PARDIS RESIDENCE

DEVELOPMENT PLAN SET 2

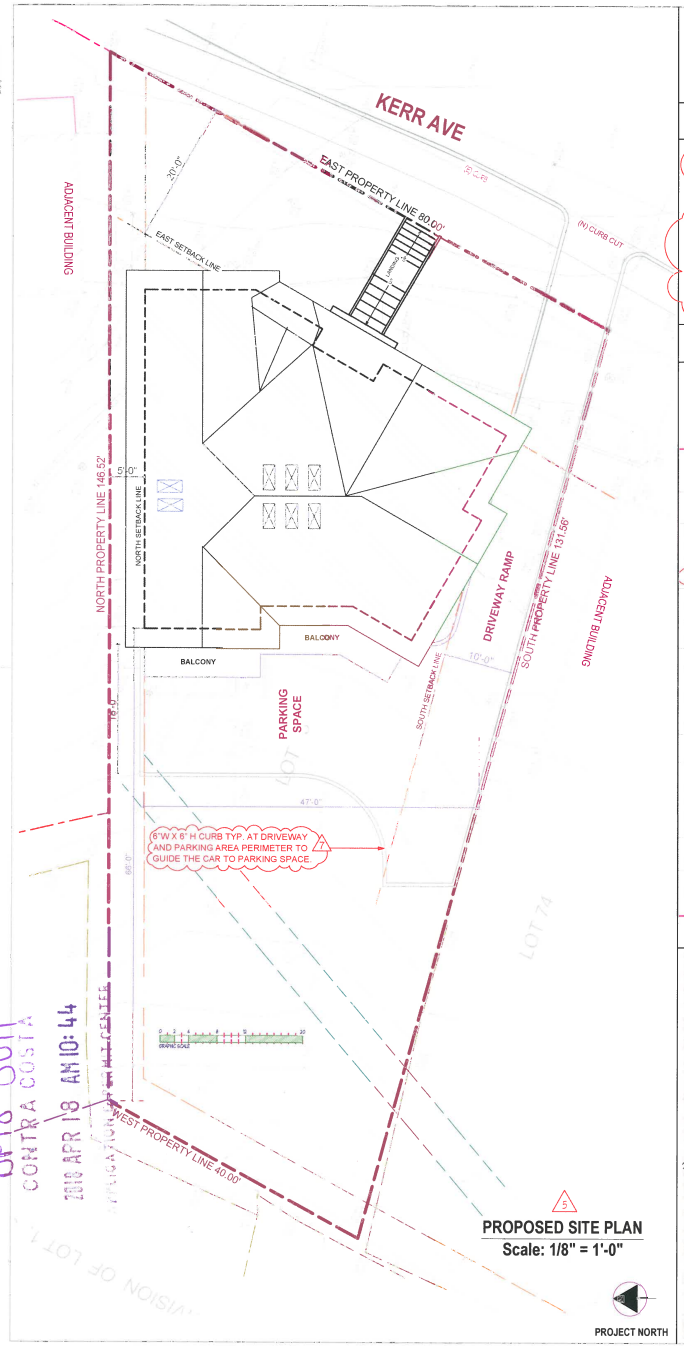

5

PROPOSED SITE PLAN
Scale: 1/8" = 1'-0"

SCOPE OF WORK: *REVISION TO AN APPROVED PLAN UNDER CONSTRUCTION*

THE FOUNDATION, EXTERIOR WALL FRAMING AND ROOF FRAMING OF THE HOUSE HAS BEEN BUILT UNDER BUILDING PERMIT BIR 16-007625 2

NEW PROJECT DESCRIPTION: 1

RELOCATE THE EXISTING CURB-CUT FROM NORTH EAST TO SHOUT EAST, BUILD A NEW DRIVEWAY TO THE BACKYARD, AND MOVE TWO OFF PARKING SPACES FROM GARAGE TO OPEN SPACE AT BACKYARD. INCORPORATE THE 472 SQ. FT. EXISTING CRAWL SPACE / MECHANICAL ROOM AT LOWER FLOOR INTO NEW LIVING SPACE, ADD 170 SQ. FT. COVERED DECK TO LOWER FLOOR. NO GRADING OR FILL IS PROPOSED AS PART OF THIS PROJECT

BUILDING INFORMATION:

PARCEL NO.	572-021-001-1
SUBDIVISION:	BEVERLY HILLS
YEAR BUILT:	2018
OCCUPANCY:	R3/ U
CONSTRUCTION TYPE:	VB
SEISMIC DESIGN CATEGORY:	D
SPRINKLERED:	No
STORIES:	2 1/2

PROJECT DATA:

OWNER	PROJECT ADDRESS	ZONING
PARDIS POORZAND 79 ARLINGTON AVE. KENSINGTON, CA. 94707 TEL: (510) 333-3524	20 KERR AVE KENSINGTON, CA. 94707	KENSINGTON COMBINING DISTRICT R-6:SINGLE FAMILY RESIDENTIAL ZONE

	REQUIRED PERMITTED	EXISTING	PROPOSED
TOTAL LOT AREA	6,000 s.f. Min	7,280.00 s.f.	No change
MAIN FLOOR LIVING AREA		1,758.00 s.f.	1,827.00 s.f. 2
LOWER FLOOR LIVING AREA		1,217.00 s.f.	1,689.00 s.f. 2
STAIRS FLOOR AREA		73.00 s.f.	85.00 s.f. Already included in Main floor area 2
UNFINISHED CRAWLSPACE 2		1,054.00 s.f.	1,054.00 s.f.
FRONT ENTRY		55.00 s.f.	65.00 s.f. 2 Already included in Main floor area 2
MAIN FL. BALCONY		250.00	250.00 s.f.
LOWER FL. BALCONY		0 s.f.	170.00 s.f. 2
GROSS FLOOR AREA	3,000.00 s.f.	2,900.00 s.f.	3,980.00 s.f. 2
BUILDING FOOTPRINT	2,512.00 s.f.	1,765.00s.f.	No Change
LOT COVERAGE	40% Max	0%	24.35%
OPEN YARD SPACE	4,368.00 s.f. Min	+5,000.00 s.f.	+ No Change
FRONT SETBACK	20'-0"	20'-0"	No Change
REAR SETBACK	15'-0"	66'-0"	No Change
LEFT SIDE SETBACK	5'-0"	10'-0"	No Change
RIGHT SIDE SETBACK	5'-0"	5'-0"	No Change
BUILDING HEIGHT	35'-0"	28'-6"	No Change
OFF-STREET PARKING	2	2	No Change

APPROVAL:

SHEET INDEX:

1. SITE PLAN, VICINITY MAPS, COPE OF WORK, PROJECT DATA,SHEET INDEX.
2. NEW PROPOSED LOWER FLOOR PLAN.
3. NEW PROPOSED MAIN FLOOR PLAN.
4. CRAWL SPACE & NEW OFF STREET PARKING LAYOUT.
5. NEW PROPOSED EXTERIOR ELEVATIONS.
6. NEW PROPOSED EXTERIOR ELEVATIONS.
7. SECTION-BB- REVISED PLAN, PASSING THROUGH AREA WHERE HAS BEEN CONVERTED INTO NEW LIVING AREA , SECTION-BB- APPROVED PLANS, SHOWING THE AREAS WHICH WILL BE CONVERTED TO NEW LIVING AREA
8. NEW PROPOSED SITE PLAN.

VICINITY MAP:

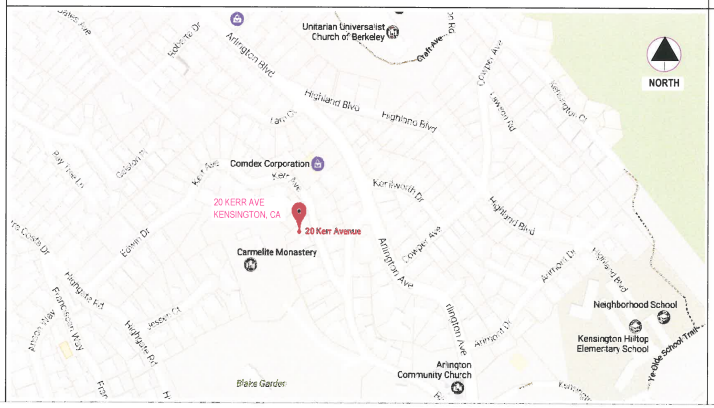

PROJECT TEAM:

DESIGNER & GENERAL CONTRACTOR
GEHL DESIGN/BUILD
79 ARLINGTON AVE.
KENSINGTON CA. 94707
TEL: (510) 812 - 1039

SURVEY
MORAN ENGINEERING, INC.
CIVIL ENGINEERING AND LAND SURVEYING
1930 SHATTUCK AVENUE SUITE A
BERKELEY, CALIFORNIA 94704
OFFICE PHONE: 510-848-1930

CIVILIDRAINAGE CONSULTANT
DAVID FRANCO/ MORAN ENGINEERING, INC.
CIVIL ENGINEERING AND LAND SURVEYING
1930 SHATTUCK AVENUE SUITE A
BERKELEY, CALIFORNIA 94704

GEOTECHNICAL CONSULTANT
EARTH MECHANICS CONSULTING ENGINEERS
360 GRAND AVENUE, SUITE 262
OAKLAND, CALIFORNIA 94610
(510) 839-0765

ENERGY CALCULATIONS (TITEL 24)
ENERGY WEST
4050 HARLAN STREET
EMERYVILLE, CA. 94608
TEL: (510) 652.4433

ARBORIST/CONSULTANT
PETER K. RUDY
CERTIFIED ARBORIST #WC3166
CALIFORNIA CONTRACTOR #740394

STRUCTURAL ENGINEER
STRUCT -TECH GROUP INC
800 SAN PABLO AVENUE
ALBANY, CA 94706
PHONE: (510) 717-1090

PARDIS RESIDENCE

Project Address
20 KERR AVE
KENSINGTON. CA 94707

Owner:
PARDIS POORZAND

Address
79 ARLINGTON AVE
KENSINGTON. CA 94707
TEL. (510) 333-3524

GEHL
DESIGN/ BUILD
DESIGN • CONSTRUCTION
79 Arlington Avenue
Kensington. CA 94707
Tel: 510. 812-1039
GEHLDESIGNBUILD@GMAIL.COM

Sheet Contents
SITE PLAN, VICINITY MAP
SCOPE OF WORK, PROJECT DATA, SHEET INDEX.

Designer

Structural Engineer

These drawings, plans and specifications are the property of GEHL Design/Build, Inc. and is protected under the copyright laws of the United States. Design/Build, Inc. is protected by law.
© 2009 GEHL Design/Build

Project No: 18 - 04

Date: January 20. 2018

Drawn By: P.P

Checked By: MP

Revisions
1. DESIGN CHANGE 5
2. Plan check comments- March 14. 2018 - Susan Johnson 6
3. Plan Check Correction Email_April 12-2018 - Susan Johnson 7
4

Sheet
A - 1 of 8

Revised
DP18-3011
2018 APR 18 AM 10:44
CONTRA COSTA

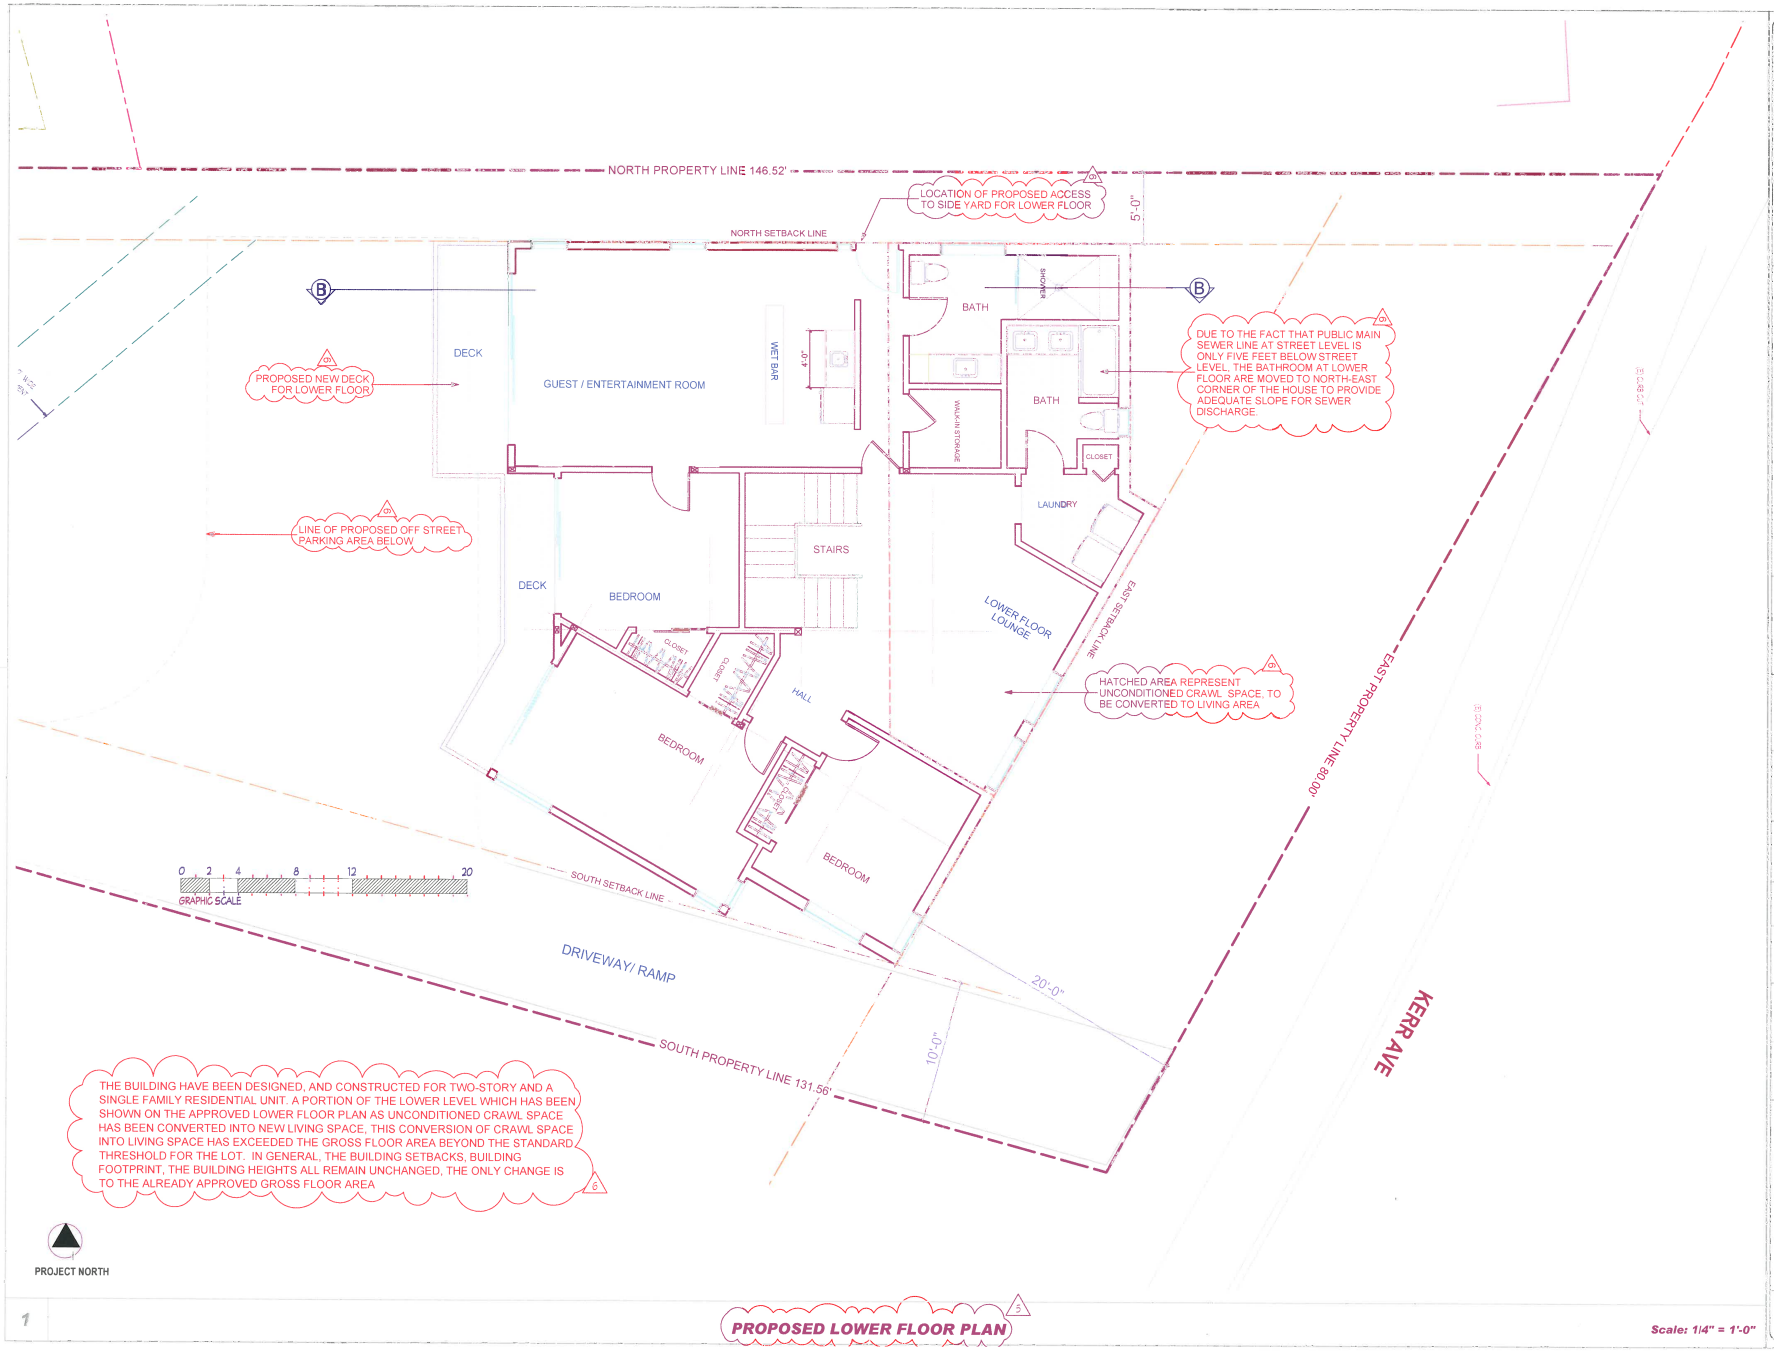

1

PROPOSED LOWER FLOOR PLAN

Scale: 1/4" = 1'-0"

PARDIS RESIDENCE

Project Address:
20 KERR AVE
KENSINGTON, CA 94707

Owner:
PARDIS POORZAND

Address:
79 ARLINGTON AVE
KENSINGTON, CA 94707
TEL: (510) 333-3524

GEHL
DESIGN/ BUILD
DESIGN • CONSTRUCTION
79 Arlington Avenue
Kensington, CA 94707
Tel: 510. 812-1039
GEHLDESIGNBUILD@GMAIL.COM

Sheet Contents:
NEW PROPOSED LOWER FLOOR PLAN

Designer:

Structural Engineer:

These designs, drawings, and specifications are the property of GEHL Design/Build, and are in part or in whole without the written permission of GEHL Design/Build, Inc. is prohibited by law.
© 2018 by GEHL Design/Build

Project No. 18 - 04

Date: January 20, 2018

Drawn By: P.P.

Checked By: MP

Revisions:
1. DESIGN CHANGE 5
2. Plan check comments March 14, 2018 - Susan Johnson 6
3. Plan Check Correction Email_April-12-2018 - Susan Johnson 7
4.

Sheet
A - 2 of 8

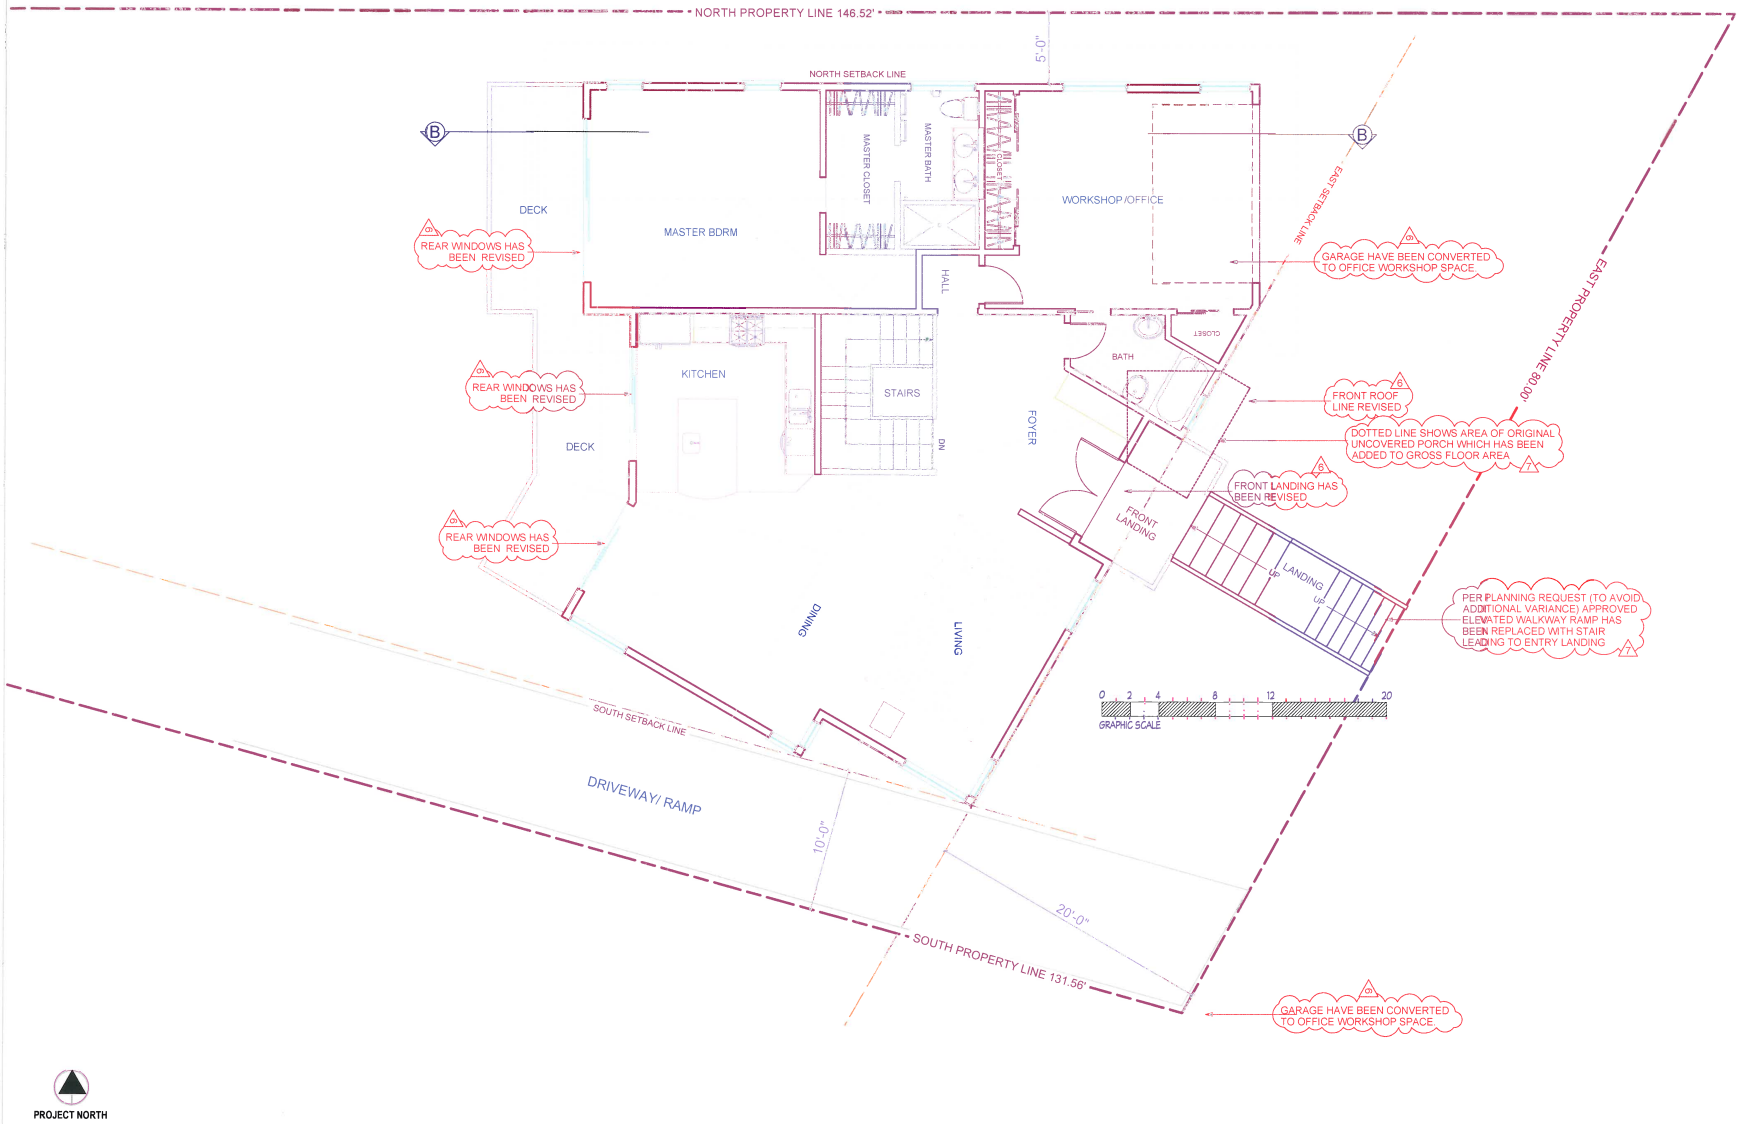

1

NEW PROPOSED MAIN FLOOR PLAN 5

Scale: 1/4" = 1'-0"

PARDIS RESIDENCE

Project Address:
20 KERR AVE
KENSINGTON, CA 94707

Owner:
PARDIS POORZAND

Address:
79 ARLINGTON AVE
KENSINGTON, CA 94707
TEL (510) 333-3524

GEHL
DESIGN/ BUILD

DESIGN ▪ CONSTRUCTION
79 Arlington Avenue
Kensington, CA 94707
Tel: 510. 812-1039

GEHLDESIGNBUILD@GMAIL.COM

Sheet Contents
NEW PROPOSED MAIN FLOOR PLAN

Designer:

Structural Engineer:

These designs, drawings and specifications are the property of GEHL Design/Build, Inc. and shall not be used or reproduced without the written permission of GEHL Design/Build, Inc. is prohibited by law.

© 2018 by GEHL Design/Build

Project No 18 - 04

Date January 20, 2018

Drawn By F.P.

Checked By MP

Revisions:
1 DESIGN CHANGE 5
2 Plan check comments- March 14, 2018 Susan Johnson 6
3 Plan Check Correction Email_April-12-2018 - Susan Johnson 7
4

Sheet
A - 3 Of 8

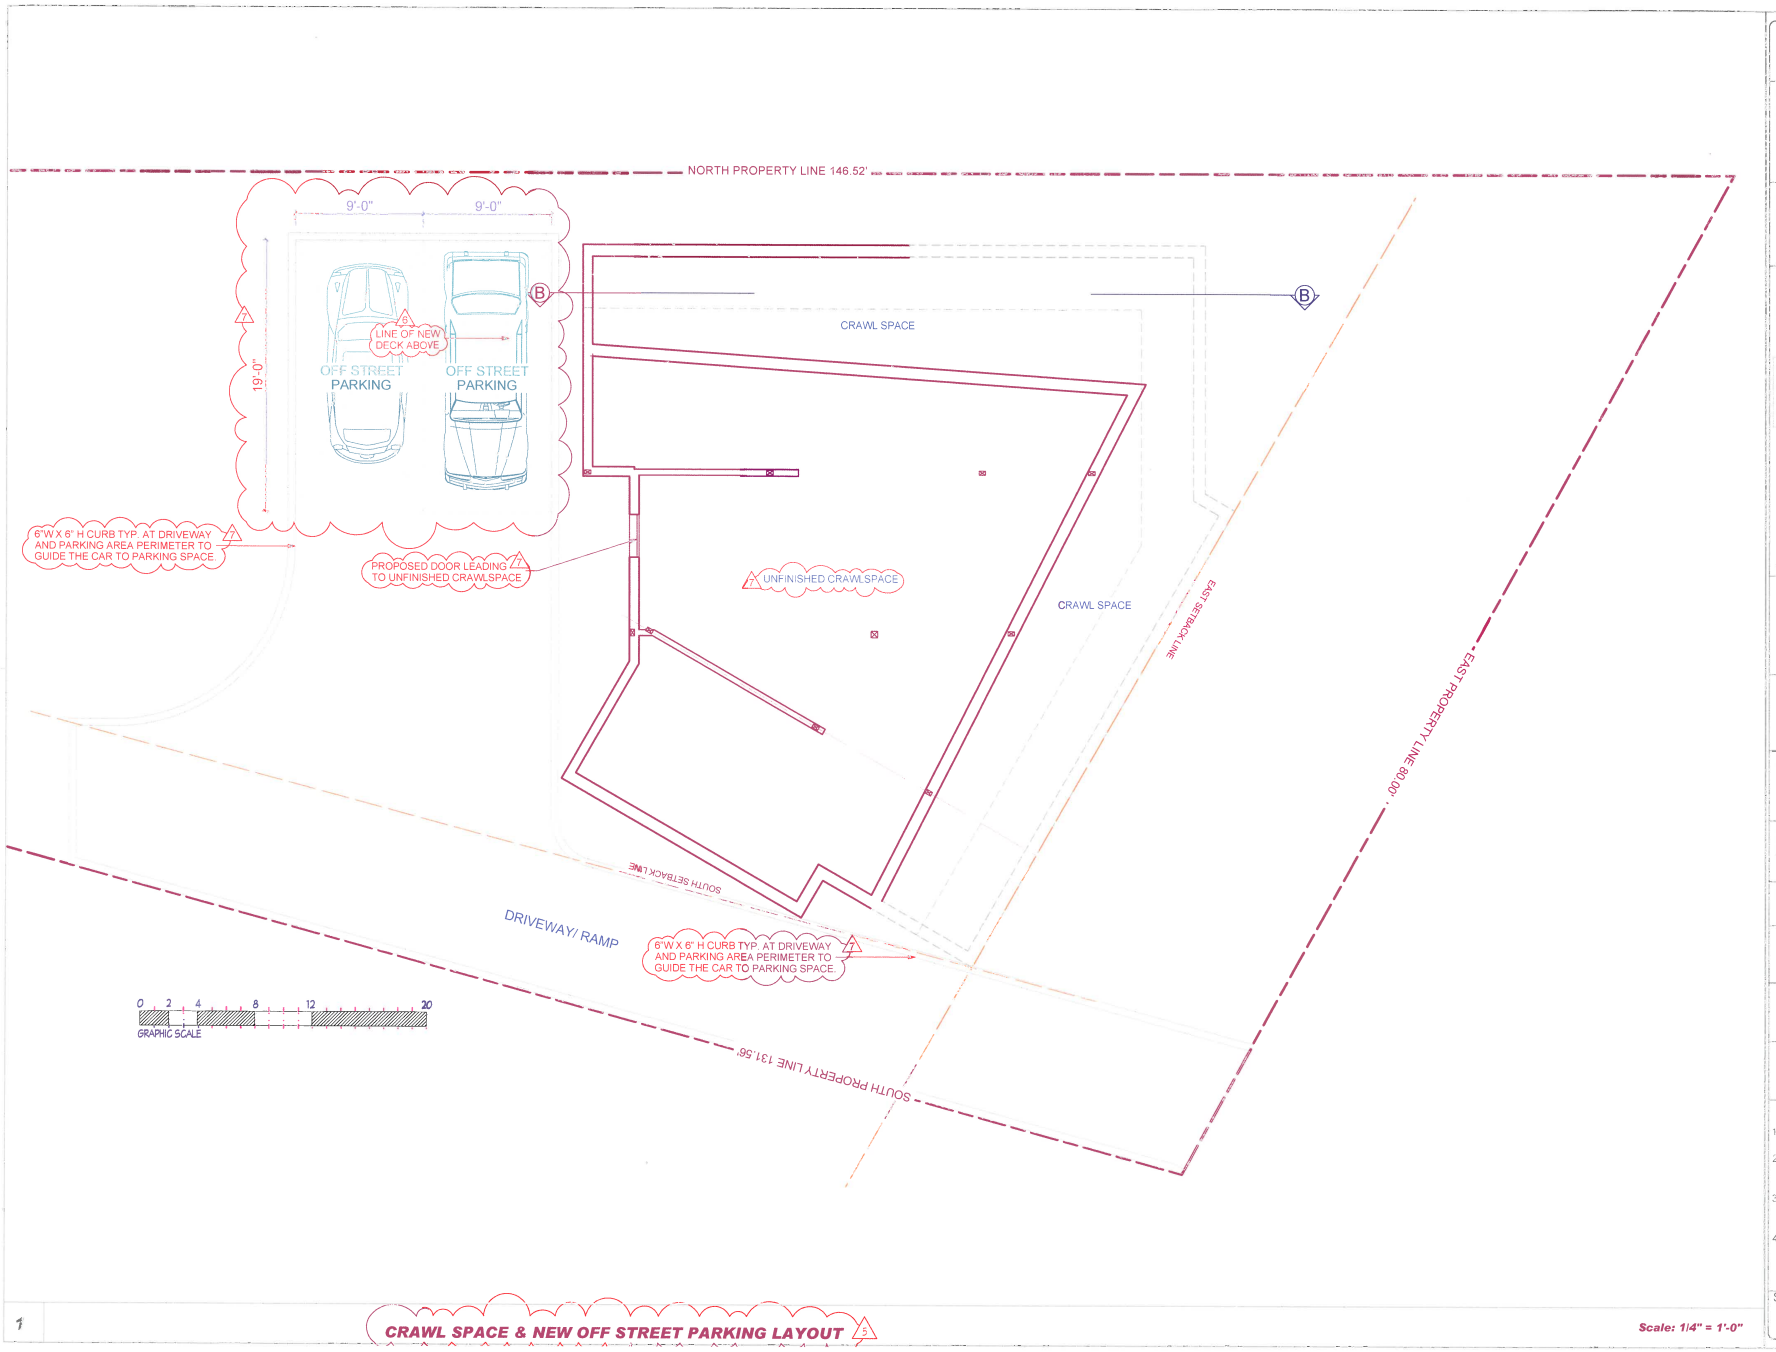

1

CRAWL SPACE & NEW OFF STREET PARKING LAYOUT 5

Scale: 1/4" = 1'-0"

PARDIS RESIDENCE

Project Address:
20 KERR AVE
KENSINGTON, CA 94707

Owner:
PARDIS POORZAND

Address:
79 ARLINGTON AVE
KENSINGTON, CA 94707
TEL: (510) 333-3524

GEHL
DESIGN/ BUILD

DESIGN = CONSTRUCTION
79 Arlington Avenue
Kensington, CA 94707
Tel: 510. 812-1039

GEHLDESIGNBUILD@GMAIL.COM

Sheet Contents:
CRAWL SPACE & NEW OFF STREET PARKING LAYOUT.

Designer:

Structural Engineer:

These designs, drawings and specifications are the property of Gehl - Design/Build. Any use is prohibited without the written permission of Gehl - Design/Build. No is prohibited to be.
© 2018 by Gehl - Design/Build

Project No: 18 - 04

Date: January 20, 2018

Drawn By: P.P.

Checked By: MP

Revisions:
1. DESIGN CHANGE 5
2. Plan check comments- March 14, 2018 - Susan Johnson 6
3. Plan Check Correction Email_April-12-2018 - Susan Johnson 7
4.

Sheet
A - 4 of 8

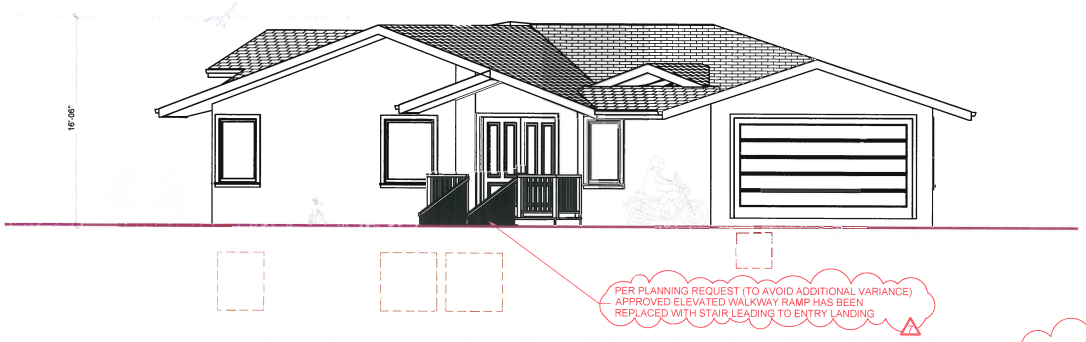

(FRONT/EAST)

0 2 4 8 12 20
GRAPHIC SCALE

THE BUILDING HAVE BEEN DESIGNED, AND CONSTRUCTED FOR TWO-STORY AND A SINGLE FAMILY RESIDENTIAL UNIT. A PORTION OF THE LOWER LEVEL WHICH HAS BEEN SHOWN ON THE APPROVED LOWER FLOOR PLAN AS UNCONDITIONED CRAWL SPACE HAS BEEN CONVERTED INTO NEW LIVING SPACE, THIS CONVERSION OF CRAWL SPACE INTO LIVING SPACE HAS EXCEEDED THE GROSS FLOOR AREA BEYOND THE STANDARD THRESHOLD FOR THE LOT. IN GENERAL, THE BUILDING SETBACKS, BUILDING FOOTPRINT, THE BUILDING HEIGHTS ALL REMAIN UNCHANGED, THE ONLY CHANGE IS TO THE ALREADY APPROVED GROSS FLOOR AREA 6

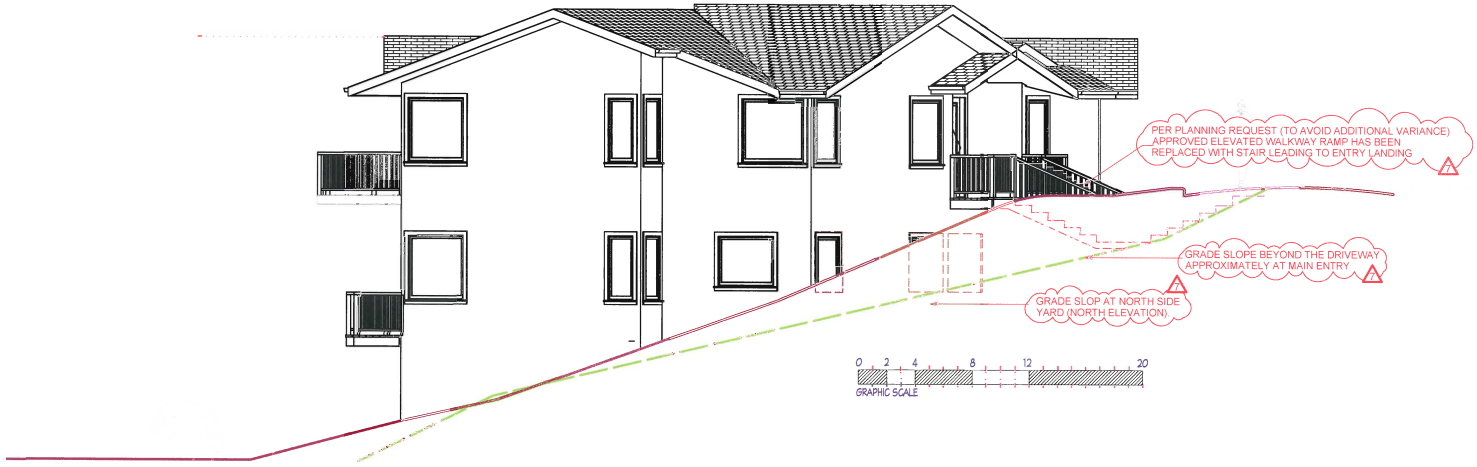

(LEFT/SOUTH)

1 **NEW PROPOSED EXTERIOR ELEVATIONS** **Scale: 1/4" = 1'-0"**

PARDIS RESIDENCE

Project Address:
20 KERR AVE
KENSINGTON, CA 94707

Owner:
PARDIS POORZAND

Address:
79 ARLINGTON AVE.
KENSINGTON, CA 94707
TEL. (510) 333-3524

GEHL
DESIGN/ BUILD

DESIGN ▪ CONSTRUCTION
79 Arlington Avenue
Kensington, CA 94707
Tel: 510. 812-1039

GEHLDESIGNBUILD@GMAIL.COM

Sheet Contents:
NEW PROPOSED EXTERIOR ELEVATIONS

Designer:

Structural Engineer:

These designs, drawings and specifications are the property of GEHL Design/Build. Any use or reproduction without the written permission of GEHL Design/Build, Inc. is prohibited by law.
© 2018 by GEHL Design/Build

Project No: 18 - 04

Date: January 20, 2018

Drawn By: P.P.

Scale: 2/9" = 1'-0"

Checked By: MP

Revisions:
1. DESIGN CHANGE 5
2. Plan check comments- March 14, 2018 - Susan Johnson 6
3. Plan Check Correction Email_April-12-2018 - Susan Johnson 7
4.

Sheet
A - 5 of 8

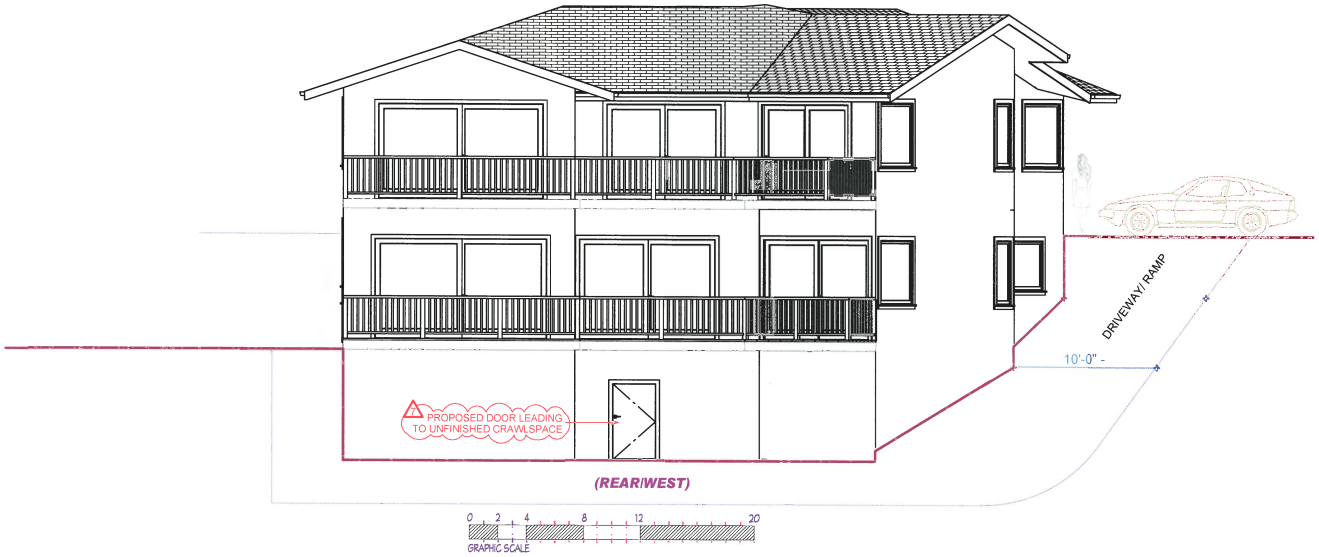

(REAR/WEST)

THE BUILDING HAVE BEEN DESIGNED, AND CONSTRUCTED FOR TWO-STORY AND A SINGLE FAMILY RESIDENTIAL UNIT. A PORTION OF THE LOWER LEVEL WHICH HAS BEEN SHOWN ON THE APPROVED LOWER FLOOR PLAN AS UNCONDITIONED CRAWL SPACE HAS BEEN CONVERTED INTO NEW LIVING SPACE, THIS CONVERSION OF CRAWL SPACE INTO LIVING SPACE HAS EXCEEDED THE GROSS FLOOR AREA BEYOND THE STANDARD THRESHOLD FOR THE LOT. IN GENERAL, THE BUILDING SETBACKS, BUILDING FOOTPRINT, THE BUILDING HEIGHTS ALL REMAIN UNCHANGED, THE ONLY CHANGE IS TO THE ALREADY APPROVED GROSS FLOOR AREA 6

(RIGHT/NORTH)

1

NEW PROPOSED EXTERIOR ELEVATIONS

Scale: 1/4" = 1'-0"

PARDIS RESIDENCE

Project Address:
20 KERR AVE
KENSINGTON, CA 94707

Owner:
PARDIS POORZAND

Address:
79 ARLINGTON AVE.
KENSINGTON, CA. 94707
TEL: (510) 333-3524

GEHL
DESIGN/ BUILD

DESIGN ▪ CONSTRUCTION
79 Arlington Avenue
Kensington, CA 94707
Tel: 510. 812-1039

GEHLDESIGNBUILD@GMAIL.COM

Sheet Contents:
NEW PROPOSED EXTERIOR ELEVATIONS

Designer:

Structural Engineer:


© 2018 by Gehl - Design/Build

Project No: 18 - 04

Date: January 20, 2018

Drawn By: P.P

Checked By: MF

Revisions:
1 DESIGN CHANGE 5
2 Plan check comments- March 14, 2018 - Susan Johnson 6
3 Plan Check Correction Email_April-12-2018 - Susan Johnson 7
4

Sheet
A - 6 of 8

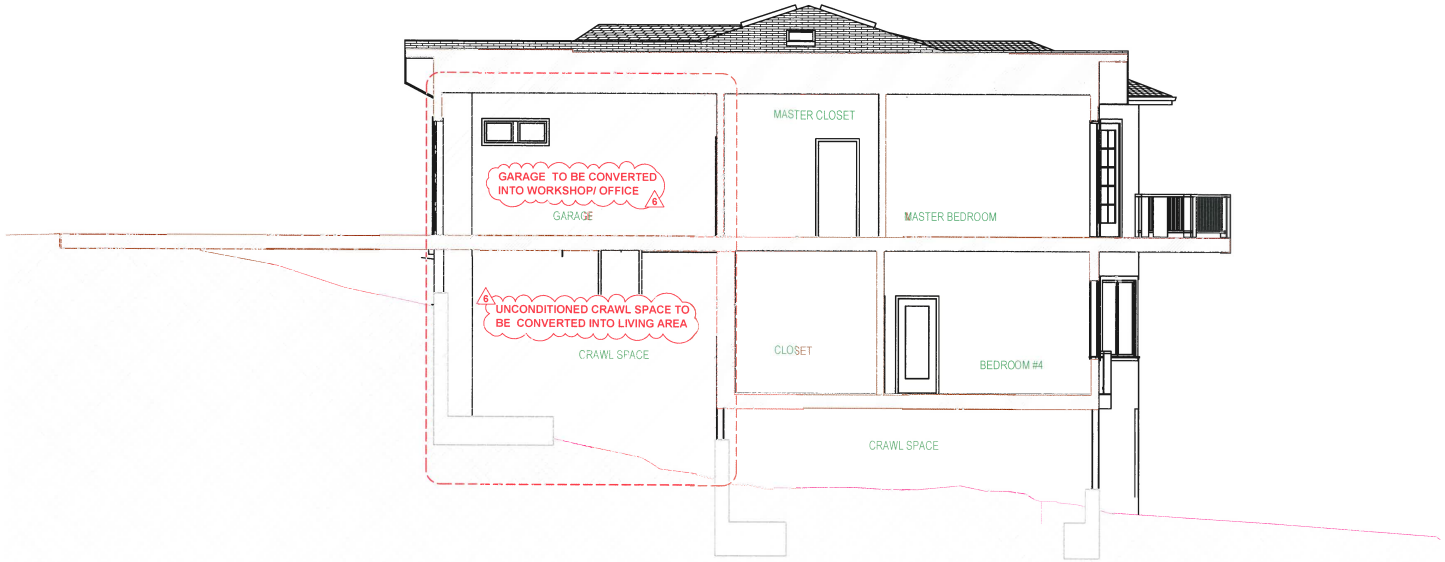

2 **SECTION-BB- APPROVED PLANS, SHOWING THE AREAS WHICH WILL BE CONVERTED TO NEW LIVING AREA** 7

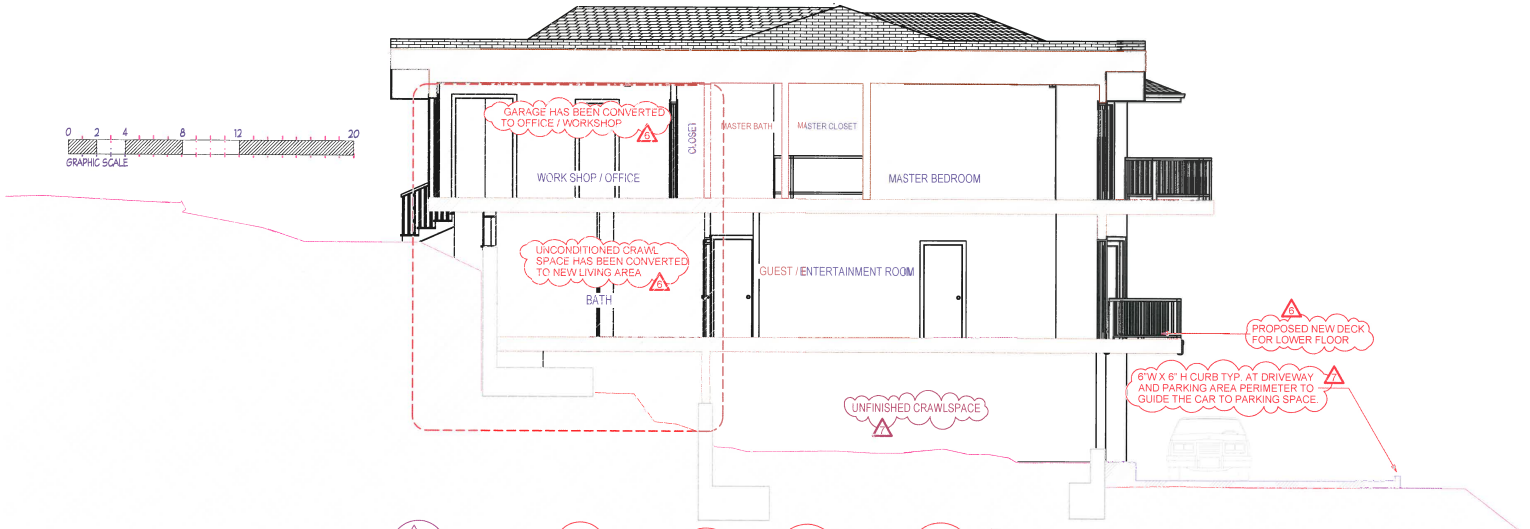

1 **SECTION-BB- REVISED PLAN, PASSING THROUGH AREA WHERE HAS BEEN CONVERTED INTO NEW LIVING AREA** 6

PARDIS RESIDENCE

Project Address:
20 KERR AVE
KENSINGTON, CA 94707

Owner:
PARDIS POORZAND

Address:
79 ARLINGTON AVE
KENSINGTON, CA. 94707
TEL: (510) 333-3524

GEHL DESIGN/ BUILD

DESIGN ▪ CONSTRUCTION
79 Arlington Avenue
Kensington, CA 94707
Tel: 510. 812-1039

GEHLDESIGNBUILD@GMAIL.COM

Sheet Contents:
SECTION-BB- REVISED PLAN, PASSING THROUGH AREA WHERE HAS BEEN CONVERTED INTO NEW LIVING AREA. SECTION-BB- APPROVED PLANS, SHOWING THE AREAS WHICH WILL BE CONVERTED TO NEW LIVING AREA.

Designer:

Structural Engineer:

These designs, drawings and specifications are the property of Gehl - Design/Build. Any use or reproduction without the written permission of Gehl - Design/Build, Inc. is prohibited by law.

© 2018 by Gehl - Design/Build

Project No. 18 - 04

Date: January 20, 2018

Drawn By: P.P.

Checked By: MP

Revisions:
1. DESIGN CHANGE 5
2. Plan check comments- March 14, 2018 - Susan Johnson 6
3. Plan Check Correction Email_April-12-2018 - Susan Johnson 7
4

Sheet
A - 7 of 8

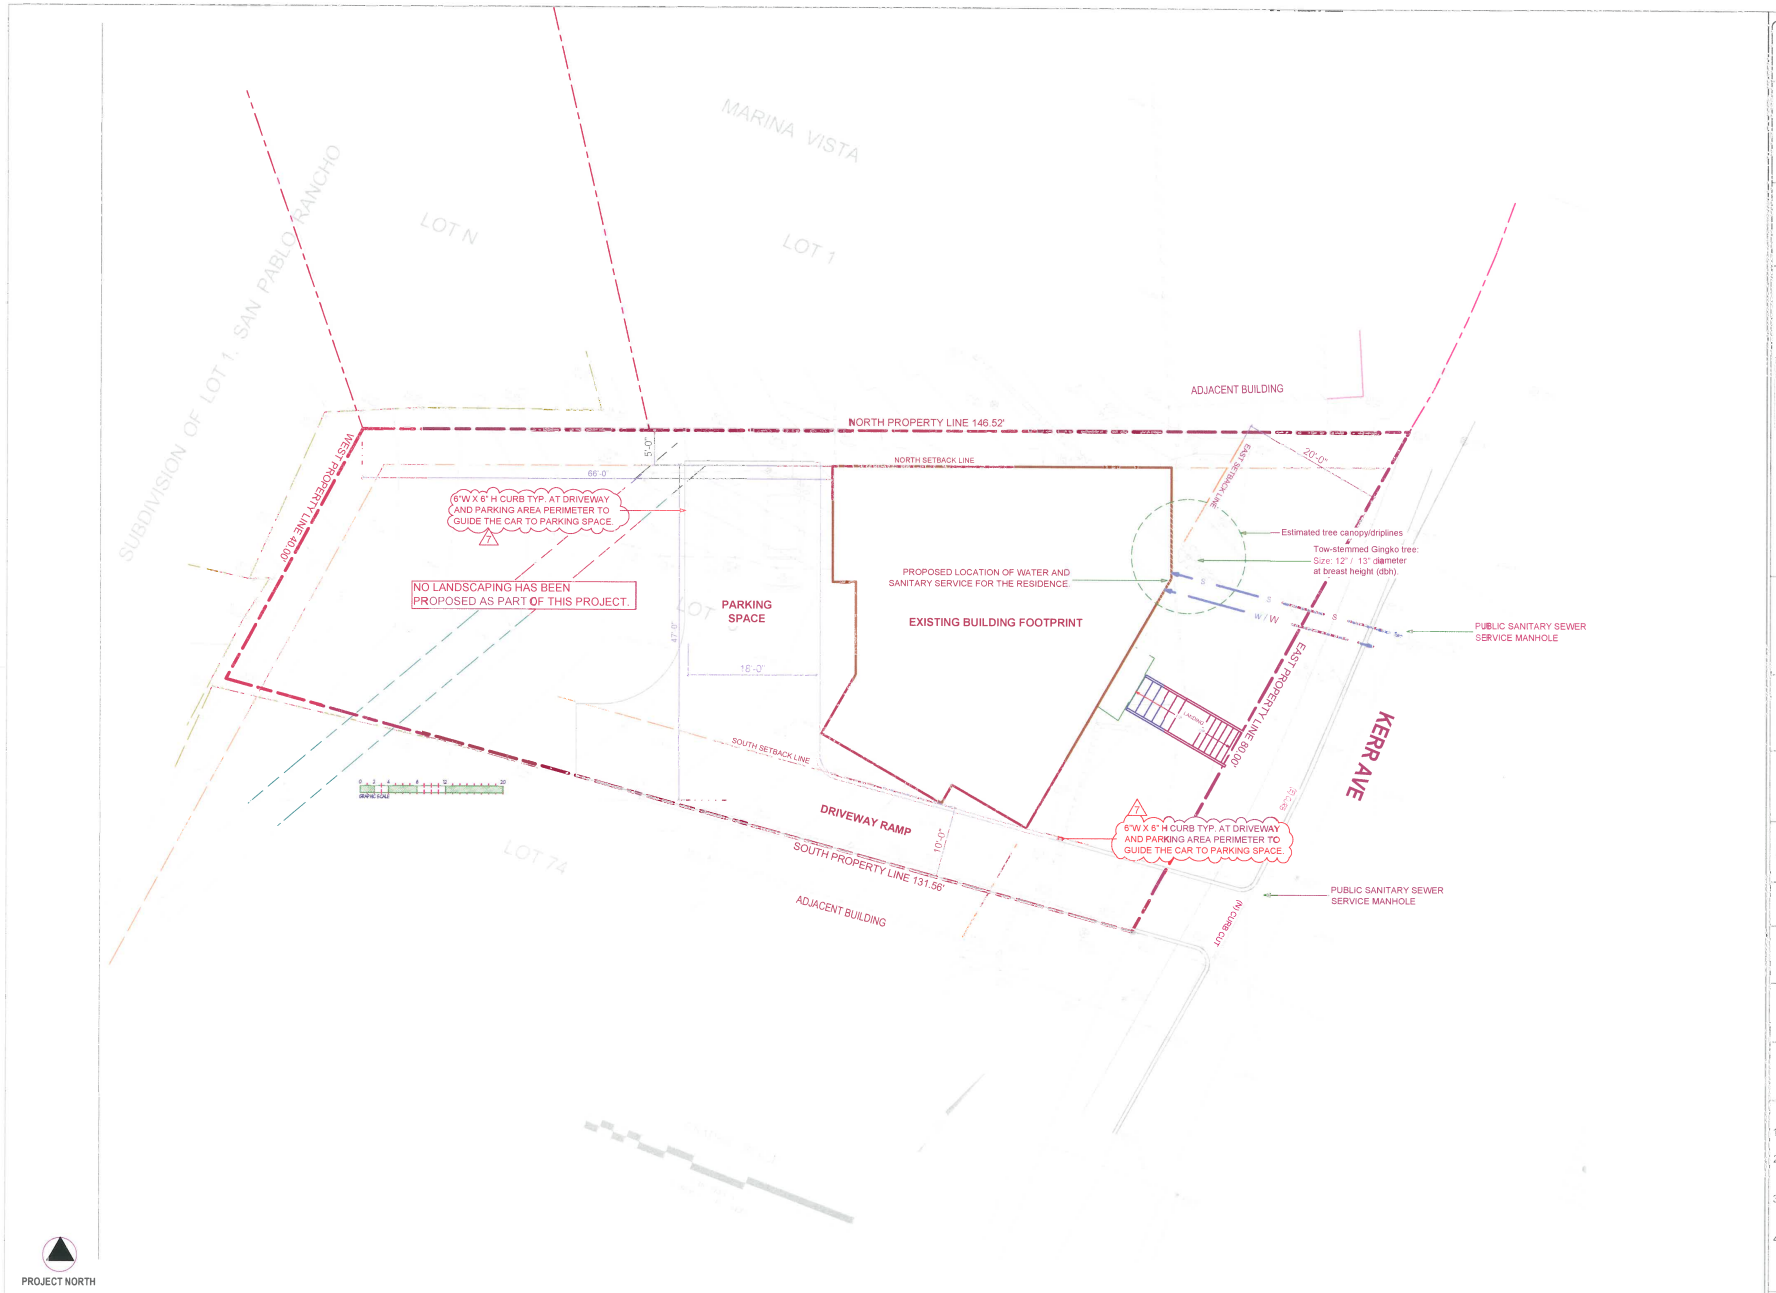

1

NEW PROPOSED SITE PLAN 7

Scale: 1/8" = 1'-0"

PARDIS RESIDENCE

Project Address:
20 KERR AVE
KENSINGTON, CA 94707

Owner:
PARDIS POORZAND

Address:
79 ARLINGTON AVE.
KENSINGTON, CA 94707
TEL: (510) 333-3524

GEHL DESIGN/ BUILD

DESIGN • CONSTRUCTION
79 Arlington Avenue
Kensington, CA 94707
Tel: 510. 812-1039

GEHLDESIGNBUILD@GMAIL.COM

Sheet Contents
NEW PROPOSED SITE PLAN

Designer

Structural Engineer

Project No. 18 - 04

Date January 20, 2018

Drawn By P.P

Checked By MF

Revisions
1 DESIGN CHANGE 5
2 Plan check comments- March 14, 2018 - Susan Johnson 6
3 Plan Check Correction Email_April-12-2018 - Susan Johnson 7
4

Sheet
A - 8 of 8